

CCO #15-007

Project: 0483-01 - Perris High School No. 4 32255 Leon Road Winchester, California 92596

Change Order #15-007: CE #020 - CCD #010 Louver Revision to B1 Lunch Shelter (Part 2 of 2)

CONTRACT FOR: CONTRACT COMPANY: **Rivco Coatings** C-0483-01-015 : Painting 25165 Briggs Road Romoland, California 92585 **DATE CREATED:** 6/15/2022 **CREATED BY:** Jaime Cheeney (Neff Construction, Inc.) **CONTRACT STATUS:** Pending - In Review **REVISION: DESIGNATED REVIEWER: REVIEWED BY: DUE DATE: REVIEW DATE: INVOICED DATE:** PAID DATE: **SCHEDULE IMPACT: EXECUTED: TOTAL AMOUNT:** \$ 34,831.91

DESCRIPTION:

CE #020 - CCD #010 Louver Revision to B1 Lunch Shelter

Painting of louvers that were previously scheduled as prefinished aluminum.

Painting of steel added in CCD #10

Additional masking

Please note that this CCO #15-007 is part 2 of 2 associated to the attached cost proposal and shall be board approved.

ATTACHMENTS:

RFI #482 - CCD #010 Proposed Louver Detail Revision.pdf

POTENTIAL CHANGE ORDERS IN THIS CHANGE ORDER:

PCO#	Title	Schedule Impact	Amount		
15-031	CE #020 - CCD #010 Louver Revision to B1 Lunch Shelter (Part 2 of 2)		34,831.91		
		TOTAL:	\$ 34,831.91		

CHANGE ORDER LINE ITEMS:

PCO # 15-031 : CE #020 - CCD #010 Louver Revision to B1 Lunch Shelter (Part 2 of 2)

#	Cost Code	Description	Туре	Amount
1	50-15000 - Painting	Paint & Mask (CCD 10)	Commitment	\$ 34,831.91
			Subtotal:	\$34,831.91
			Grand Total:	\$34,831.91

The original (Contract Sum) \$841,527.00

Net change by previously authorized Change Orders \$ 84,151.69
The contract sum prior to this Change Order was \$ 925,678.69

The contract sum would be changed by this Change Order in the amount of \$34,831.91

The new contract sum including this Change Order will be \$960,510.60

The contract time will not be changed by this Change Order





BakerNowicki Design Studio 731 Ninth Avenue, Suite A

731 Ninth Avenue, Suite A San Diego California 92101 Buddy Gessel

DocuSigned by:

—F17C7254922A46E...

6/15/2022

SIGNATURE DATE

Rivco Coatings 25165 Briggs Road Romoland California 92585

DocuSigned by:
Perfect Conjunction

6/15/2022

SIGNATURE DATE

Perris Union High School District 155 East 4th Street Perris California 92570

DocuSigned by:

Hector Gonzaleg/16/2022

SIGNATURE DATE

Neff Construction, Inc. page 2 of 2 Printed On: 6/15/ 2022 03:06 PM



PCO #15-031

Project: 0483-01 - Perris High School No. 4 32255 Leon Road Winchester, California 92596

Potential Change Order #15-031: CE #020 - CCD #010 Louver Revision to B1 Lunch Shelter (Part 2 of 2)

		•	,
CONTRACT COMPANY:	Rivco Coatings 25165 Briggs Road Romoland California, 92585	CONTRACT FOR:	C-0483-01-015 - Painting
PCO NUMBER/REVISION:	15-031 / 0	CREATED BY:	Jeff Nicholson (Neff Construction, Inc.)
REQUEST RECEIVED FROM:		CREATED DATE:	6/15 /2022
STATUS:	Pending - In Review		
REFERENCE:			
FIELD CHANGE:	No	ACCOUNTING METHOD:	Amount Based
LOCATION:		PAID IN FULL:	No
SCHEDULE IMPACT:		TOTAL AMOUNT:	\$34,831.91

POTENTIAL CHANGE ORDER TITLE: CE #020 - CCD #010 Louver Revision to B1 Lunch Shelter (Part 2 of 2)

CHANGE REASON: Design Development

POTENTIAL CHANGE ORDER DESCRIPTION: (The Contract Is Changed As Follows)

CE #020 - CCD #010 Louver Revision to B1 Lunch Shelter

Painting of louvers that were previously scheduled as prefinished aluminum.

Painting of steel added in CCD #10

Additional masking

Please note that this CCO #15-007 is part 2 of 2 associated to the attached cost proposal and shall be board approved.

ATTACHMENTS:

RFI #482 - CCD #010 Proposed Louver Detail Revision.pdf

#	Cost Code	Description	Туре	Amount
1	50-15000 - Painting	Paint & Mask (CCD 10)	Commitment	\$ 34,831.91
			Subtotal:	\$34,831.91
			Grand Total:	\$34,831.91

By signing below signatory recognizes and accepts the above dollar value contract adjustment								
Owner's Representa	ative		Architect					
See CCO #15-007	for approval signatures							
Print	Sign	Date	Print	Sign	Date			
Construction Manager			Prime Contractor					
Print	Sign	Date	Print	Sign	Date			

Total Cost of \$88,231.91 shall be processed as two CCO's.:

CCO #15-006 - \$53,400.00 CCO #15-007 \$34,831.91 - Will Require Board Approval due to exceeding the 10% of Change Orders

RIVCO Coatings, Inc.

251695 Briggs Road Menifee, CA 92585 Phone (951) 878-7081 Fax (951) 878-7879

Thank you for the opportunity to provide services for your project. This proposal includes all labor, materials taxes and stanard insurance in order to perform and complete painting operations pursuant to PDCA standard and the attached scope of work. Please note, our pricing and services are according to the specification listed in Sectiion 09900-Painting and Protective Coating. Material cost increase during contract work is subject to change with writing notice to the contractor.

Change order				
PROJECT NAME:	PERRIS #4 LIBER			
Date:	6/13/2022			Fax NO.
То:	NEFF Constructi	<u>—</u>		
Attn:	Jeff Nicholson			
Prep Work:	Louvers CCD#10 B-	1 lunch chaltar		
riep work.		1 Iulicii Sileitei		
	Cover floors-			
	Covering Prefinishe	ed metal at Admin BLDG#	‡A also Glass	in B-1
	cover ski lights at lu	unch shelter		
	Etch & wash galvan	nize Louvers and use Galv	anize prime	r and
	2 coats of finish Ari	stoshield finish paint		
Sections:		9900 Painting		
Your Refence No.		RFI # 882 CCD #010		•
				•
Change Order Price:				
Labor:	795 hrs	Hrs: \$74.4	2 Subtotal:	\$59,171.85
Materials krut kutter	1 box duct tape	2mil plastic		\$3,000.00
primer & Paint	190 gls	\$42.0		\$7,980.00
Equipment booms	2,500 per month	3 /40ft booms	S	\$7,500.00
Mark Up			12.5%	\$9,706.48
Bid Bond			1%	\$873.58
			TOTAL:	\$88,231.91
		<u> </u>	<u> </u>	
Material: Paint and Primer			Subtotal:	
			Subtotal:	
Mark Up:			12.5%	
Bid bond:				
			TOTAL:	
Quote Reflection	point was send out t	o the job site tinted wrong	color had m	y painters
	sitting around at the	job site waiting for the pair	nt coulnt send	I them home
	because we were wo	eking on the Island of Cata	lina	
Owner Acceptance				
Upon acceptance of this agreem	ent, you are stating th	at you are authorized to co	ntract work o	n behalf of the
company. You are also accepting	-			
acceptance and incorporated 10		·		
by RIVCO Coatings, Inc. If you ha				
Rivco office at (951) 878-7081.			-	
				6/13/2022
Authorized by: (Print/Title/Signa	ture)			Date





Neff Construction, Inc.

BY

Project: 0483-01 - Perris High School No. 4 32255 Leon Road

Winchester, California 92596

TO: Ben Pitts (KNA Consulting Engineers, Inc.) Leo Contreras (BakerNowicki Design Studio) FROM: Roy Wager (Neff Construction, Inc.) 1701 South Bon View Avenue Ontario, California 91761 DATE INITIATED: 03/02/2020 STATUS: Closed on 03/04/20 LOCATION: Bidg. B1 DUE DATE: 03/09/2020 COST CODE: REFERENCE: COST IMPACT: SCHEDULE IMPACT: DRAWINGS NUMBER: CCD #010 (X-090) SPEC SECTION: LINKED DRAWINGS: RECEIVED FROM: Lonnie Gallaher (KCB Towers, Inc.) COPIES TO: Jaime Castro (Neff Construction, Inc.), Curtis Fletcher (Neff Construction, Inc.), Buddy Gessel (BakerNowicki Design Studio), Jason Homback (Neff Construction, Inc.), and Moller (Neff Construction, Inc.), Jake Mosby (Neff Construction, Inc.), Jeff Nicholson (Neff Construction, Inc.), Brittan Reed (Neff Construction, Inc.) at 03:35 PM on 03/02/2020 In response to constructibility concerns of the CCD 010 louver detail, please see the attached proposed louver detail for approval. It is likely that the approved CCD detail will result in many of the #14 screws breaking when trying to install and that this type of field install will be difficult to complete from the top of the structure, as would be required. Please consider as shown on the attached sketch utilizing welded clips that may be shop fabricated, and a bolted connection to allow for increased installation tolerances in the field. Additionally, please verify the spacing of the louver start locations requested on the sketch. Attachments: 04-11475_140_010_Lunch Shelter Louver(Approved), pdf PERRIS – BISS – Proposed Alternative LOUVER DETAILS.pdf Official Response: Loc Contreras (BakerNowicki Design Studio) responded on Wednesday, March 4th, 2020 at 11:24AM PST -The proposed attachment detail is acceptable for the louvers. RNA Ben Pitts Spacing of louver start location is acceptable at 2:0° per provided sketch. BNG Leo Contreras Attachments:		CCD #010 Proposed Louver Detail Revision				
LOCATION: Bldg. B1 DUE DATE: 03/09/2020 COST CODE: REFERENCE: COST IMPACT: SCHEDULE IMPACT: DRAWING NUMBER: CCD #010 (X-090) SPEC SECTION: LINKED DRAWINGS: RECEIVED FROM: Lonnie Gallaher (KCB Towers, Inc.) COPIES TO: Jaime Castro (Neff Construction, Inc.), Curtis Fletcher (Neff Construction, Inc.), Buddy Gessel (BakerNowicki Design Studio), Jason Hornback (Neff Construction, Inc.), Karl Moller (Neff Construction, Inc.), Jake Mosby (Neff Construction, Inc.), Jeff Nicholson (Neff Construction, Inc.), Brittan Reed (Neff Construction, Inc.) Respective of the struction of the CCD 010 louver detail, please see the attached proposed louver detail for approval. It is likely that the approved CCD detail will result in many of the #14 screws breaking when trying to install and that this type of field install will be difficult to complete from the top of the structure, as would be required. Please consider as shown on the attached sketch utilizing welded clips that may be shop fabricated, and a bolted connection to allow for increased installation tolerances in the field. Additionally, please verify the spacing of the louver start locations requested on the sketch. Attachments: Attachments: Official Response: Leo Contreras (BakerNowicki Design Studio) responded on Wednesday, March 4th, 2020 at 11:24AM PST -The proposed attachment detail is acceptable for the louvers. KNA Ben Pitts -Spacing of louver start location is acceptable at 2-0" per provided sketch. BNds Leo Contreras	TO:		FROM:	1701 South Bon View Avenue		
COST CODE: REFERENCE: COST IMPACT: SCHEDULE IMPACT: DRAWING NUMBER: CCD #010 (X-090) SPEC SECTION: LINKED DRAWINGS: RECEIVED FROM: Lonnie Gallaher (KCB Towers, Inc.) COPIES TO: Jaime Castro (Neff Construction, Inc.), Curtis Fletcher (Neff Construction, Inc.), Buddy Gessel (BakerNowicki Design Studio), Jason Hornback (Neff Construction, Inc.), Karl Moller (Neff Construction, Inc.), Jake Mosby (Neff Construction, Inc.), Jeff Nicholson (Neff Construction, Inc.), Brittan Reed (Neff Construction, Inc.) Response to constructibility concerns of the CCD 010 louver detail, please see the attached proposed louver detail for approval. It is likely that the approved CCD detail will result in many of the #14 screws breaking when trying to install and that this type of field install will be difficult to complete from the top of the structure, as would be required. Please consider as shown on the attached sketch utilizing welded clips that may be shop fabricated, and a bolted connection to allow for increased installation tolerances in the field. Additionally, please verify the spacing of the louver start locations requested on the sketch. Attachments: Official Response: Leo Contreras (BakerNowicki Design Studio) responded on Wednesday, March 4th, 2020 at 11:24AM PST -The proposed attachment detail is acceptable for the louvers. KNA Ben Pitts -Spacing of louver start location is acceptable at 2'-0" per provided sketch. BNds Leo Contreras	DATE INITIATED:	03/02/ 2020	STATUS:	Closed on 03/04/20		
COST IMPACT: DRAWING NUMBER: CCD #010 (X-090) SPEC SECTION: LINKED DRAWINGS: RECEIVED FROM: Lonnie Gallaher (KCB Towers, Inc.) COPIES TO: Jaime Castro (Neff Construction, Inc.), Curtis Fletcher (Neff Construction, Inc.), Buddy Gessel (BakerNowicki Design Studio), Jason Hornback (Neff Construction, Inc.), Received From the Construction, Inc.), Jake Mosby (Neff Construction, Inc.), Jeff Nicholson (Neff Construction, Inc.), Brittan Reed (Neff Construction, Inc.) Received From Roy Wager (Neff Construction, Inc.) at 03:36 PM on 03/02/2020 In response to constructibility concerns of the CCD 010 louver detail, please see the attached proposed louver detail for approval. It is likely that the approved CCD detail will result in many of the #14 screws breaking when trying to install and that this type of field install will be difficult to complete from the top of the structure, as would be required. Please consider as shown on the attached sketch utilizing welded clips that may be shop fabricated, and a bolted connection to allow for increased installation tolerances in the field. Additionally, please verify the spacing of the louver start locations requested on the sketch. Attachments: 04-114675_140_010_Lunch Shelter Louver(Approved).pdf PERRIS - BISS - Proposed Alternative LOUVER DETAILS.pdf Official Response: Leo Contreras (BakerNowicki Design Studio) responded on Wednesday, March 4th, 2020 at 11:24AM PST - The proposed attachment detail is acceptable for the louvers. KNA Ben Pitts - Spacing of louver start location is acceptable at 2'-0" per provided sketch. BNds Leo Contreras	LOCATION:	Bldg. B1	DUE DATE:	03/09/2020		
DRAWING NUMBER: CCD #010 (X-090) SPEC SECTION: LINKED DRAWINGS: RECEIVED FROM: Lonnie Gallaher (KCB Towers, Inc.) COPIES TO: Jaime Castro (Neff Construction, Inc.), Curtis Fletcher (Neff Construction, Inc.), Buddy Gessel (BakerNowicki Design Studio), Jason Hornback (Neff Construction, Inc.), Karl Moller (Neff Construction, Inc.), Jake Mosby (Neff Construction, Inc.), Jeff Nicholson (Neff Construction, Inc.), Brittan Reed (Neff Construction, Inc.) Guestion from Roy Wager (Neff Construction, Inc.) at 03:36 PM on 03/02/2020 In response to constructibility concerns of the CCD 010 louver detail, please see the attached proposed louver detail for approval. It is likely that the approved CCD detail will result in many of the #14 screws breaking when trying to install and that this type of field install will be difficult to complete from the top of the structure, as would be required. Please consider as shown on the attached sketch utilizing welded clips that may be shop fabricated, and a bolted connection to allow for increased installation tolerances in the field. Additionally, please verify the spacing of the louver start locations requested on the sketch. Attachments: 04-114675_140_010_Lunch Shelter Louver(Approved).pdf PERRIS - BISS - Proposed Alternative LOUVER DETAILS.pdf Official Response: Leo Contreras (BakerNowicki Design Studio) responded on Wednesday, March 4th, 2020 at 11:24AM PST - The proposed attachment detail is acceptable for the louvers. KNA Ben Pitts - Spacing of louver start location is acceptable at 2'-0" per provided sketch. BNds Leo Contreras	COST CODE:		REFERENCE:			
LINKED DRAWINGS: RECEIVED FROM: Lonnie Gallaher (KCB Towers, Inc.) COPIES TO: Jaime Castro (Neff Construction, Inc.), Curtis Fletcher (Neff Construction, Inc.), Buddy Gessel (BakerNowicki Design Studio), Jason Hornback (Neff Construction, Inc.), Karl Moller (Neff Construction, Inc.), Jake Mosby (Neff Construction, Inc.), Jeff Nicholson (Neff Construction, Inc.), Brittan Reed (Neff Construction, Inc.) Question from Roy Wager (Neff Construction, Inc.) at 03:36 PM on 03/02/2020 In response to constructibility concerns of the CCD 010 louver detail, please see the attached proposed louver detail for approval. It is likely that the approved CCD detail will result in many of the #14 screws breaking when trying to install and that this type of field install will be difficult to complete from the top of the structure, as would be required. Please consider as shown on the attached sketch utilizing welded clips that may be shop fabricated, and a bolted connection to allow for increased installation tolerances in the field. Additionally, please verify the spacing of the louver start locations requested on the sketch. Attachments: 04-114075_140_010_Lunch Shelter Louver(Approved).pdf PERRIS - BISS - Proposed Alternative LOUVER DETAILS.pdf Official Response: Leo Contreras (BakerNowicki Design Studio) responded on Wednesday, March 4th, 2020 at 11:24AM PST -The proposed attachment detail is acceptable for the louvers. KNA Ben Pitts -Spacing of louver start location is acceptable at 2'-0" per provided sketch. BNds Leo Contreras	COST IMPACT:		SCHEDULE IMPA	ACT:		
RECEIVED FROM: Lonnie Gallaher (KCB Towers, Inc.) COPIES TO: Jaime Castro (Neff Construction, Inc.), Curtis Fletcher (Neff Construction, Inc.), Buddy Gessel (BakerNowicki Design Studio), Jason Hornback (Neff Construction, Inc.), Karl Moller (Neff Construction, Inc.), Jake Mosby (Neff Construction, Inc.), Jeff Nicholson (Neff Construction, Inc.), Brittan Reed (Neff Construction, Inc.) Question from Roy Wager (Neff Construction, Inc.) at 03:36 PM on 03/02/2020 In response to constructibility concerns of the CCD 010 louver detail, please see the attached proposed louver detail for approval. It is likely that the approved CCD detail will result in many of the #14 screws breaking when trying to install and that this type of field install will be difficult to complete from the top of the structure, as would be required. Please consider as shown on the attached sketch utilizing welded clips that may be shop fabricated, and a bolted connection to allow for increased installation tolerances in the field. Additionally, please verify the spacing of the louver start locations requested on the sketch. Attachments: 04-114675_140_010_Lunch Shelter Louver(Approved).pdf PERRIS - BISS - Proposed Alternative LOUVER DETAILS.pdf Official Response: Leo Contreras (BakerNowicki Design Studio) responded on Wednesday, March 4th, 2020 at 11:24AM PST -The proposed attachment detail is acceptable for the louvers. KNA Ben Pitts -Spacing of louver start location is acceptable at 2'-0" per provided sketch. BNds Leo Contreras	DRAWING NUMBER:	CCD #010 (X-090)	SPEC SECTION:			
COPIES TO: Jaime Castro (Neff Construction, Inc.), Curtis Fletcher (Neff Construction, Inc.), Buddy Gessel (BakerNowicki Design Studio), Jason Hornback (Neff Construction, Inc.), Karl Moller (Neff Construction, Inc.), Jake Mosby (Neff Construction, Inc.), Jeff Nicholson (Neff Construction, Inc.), Brittan Reed (Neff Construction, Inc.) Question from Roy Wager (Neff Construction, Inc.) at 03:36 PM on 03/02/2020 In response to constructibility concerns of the CCD 010 louver detail, please see the attached proposed louver detail for approval. It is likely that the approved CCD detail will result in many of the #14 screws breaking when trying to install and that this type of field install will be difficult to complete from the top of the structure, as would be required. Please consider as shown on the attached sketch utilizing welded clips that may be shop fabricated, and a bolted connection to allow for increased installation tolerances in the field. Additionally, please verify the spacing of the louver start locations requested on the sketch. Attachments: 0-114675_140_010_Lunch Shelter Louver(Approved), pdf PERRIS - B1SS - Proposed Alternative LOUVER DETAILS.pdf Official Response: Leo Contreras (BakerNowicki Design Studio) responded on Wednesday, March 4th, 2020 at 11:24AM PST -The proposed attachment detail is acceptable for the louvers. KNA Ben Pitts -Spacing of louver start location is acceptable at 2"-0" per provided sketch. BNds Leo Contreras	LINKED DRAWINGS:					
Jaime Castro (Neff Construction, Inc.), Curtis Fletcher (Neff Construction, Inc.), Buddy Gessel (BakerNowicki Design Studio), Jason Hornback (Neff Construction, Inc.), Karl Moller (Neff Construction, Inc.), Jake Mosby (Neff Construction, Inc.), Jeff Nicholson (Neff Construction, Inc.), Brittan Reed (Neff Construction, Inc.) Question from Roy Wager (Neff Construction, Inc.) at 03:36 PM on 03/02/2020 In response to constructibility concerns of the CCD 010 louver detail, please see the attached proposed louver detail for approval. It is likely that the approved CCD detail will result in many of the #14 screws breaking when trying to install and that this type of field install will be difficult to complete from the top of the structure, as would be required. Please consider as shown on the attached sketch utilizing welded clips that may be shop fabricated, and a bolted connection to allow for increased installation tolerances in the field. Additionally, please verify the spacing of the louver start locations requested on the sketch. Attachments: 04-114675_140_010_Lunch Shelter Louver(Approved).pdf PERRIS - BISS - Proposed Alternative LOUVER DETAILS.pdf Official Response: Leo Contreras (BakerNowicki Design Studio) responded on Wednesday, March 4th, 2020 at 11:24AM PST -The proposed attachment detail is acceptable for the louvers. KNA Ben Pitts -Spacing of louver start location is acceptable at 2'-0" per provided sketch. BNds Leo Contreras	RECEIVED FROM:	Lonnie Gallaher (KCB Towers, Inc.)				
In response to constructibility concerns of the CCD 010 louver detail, please see the attached proposed louver detail for approval. It is likely that the approved CCD detail will result in many of the #14 screws breaking when trying to install and that this type of field install will be difficult to complete from the top of the structure, as would be required. Please consider as shown on the attached sketch utilizing welded clips that may be shop fabricated, and a bolted connection to allow for increased installation tolerances in the field. Additionally, please verify the spacing of the louver start locations requested on the sketch. Attachments: 04-114675_140_010_ Lunch Shelter Louver(Approved).pdf PERRIS - BISS - Proposed Alternative LOUVER DETAILS.pdf Official Response: Leo Contreras (BakerNowicki Design Studio) responded on Wednesday, March 4th, 2020 at 11:24AM PST -The proposed attachment detail is acceptable for the louvers. KNA Ben Pitts -Spacing of louver start location is acceptable at 2'-0" per provided sketch. BNds Leo Contreras	(Neff Construction, Ir Brittan Reed (Neff Con	nc.), Karl Moller (Neff Construction, Inc.), Jake Most nstruction, Inc.)	oy (Neff Construction	on, Inc.), Jeff Nicholson (Neff Construction, Inc.),		
It is likely that the approved CCD detail will result in many of the #14 screws breaking when trying to install and that this type of field install will be difficult to complete from the top of the structure, as would be required. Please consider as shown on the attached sketch utilizing welded clips that may be shop fabricated, and a bolted connection to allow for increased installation tolerances in the field. Additionally, please verify the spacing of the louver start locations requested on the sketch. Attachments: 04-114675_140_010_Lunch Shelter Louver(Approved).pdf PERRIS - B1SS - Proposed Alternative LOUVER DETAILS.pdf Official Response: Leo Contreras (BakerNowicki Design Studio) responded on Wednesday, March 4th, 2020 at 11:24AM PST -The proposed attachment detail is acceptable for the louvers. KNA Ben Pitts -Spacing of louver start location is acceptable at 2'-0" per provided sketch. BNds Leo Contreras						
difficult to complete from the top of the structure, as would be required. Please consider as shown on the attached sketch utilizing welded clips that may be shop fabricated, and a bolted connection to allow for increased installation tolerances in the field. Additionally, please verify the spacing of the louver start locations requested on the sketch. Attachments: 04-114675 140 010 Lunch Shelter Louver(Approved).pdf PERRIS - BISS - Proposed Alternative LOUVER DETAILS.pdf Official Response: Leo Contreras (BakerNowicki Design Studio) responded on Wednesday, March 4th, 2020 at 11:24AM PST -The proposed attachment detail is acceptable for the louvers. KNA Ben Pitts -Spacing of louver start location is acceptable at 2'-0" per provided sketch. BNds Leo Contreras	·		·			
installation tolerances in the field. Additionally, please verify the spacing of the louver start locations requested on the sketch. Attachments: 04-114675_140_010_Lunch Shelter Louver(Approved).pdf PERRIS - B1SS - Proposed Alternative LOUVER DETAILS.pdf Official Response: Leo Contreras (BakerNowicki Design Studio) responded on Wednesday, March 4th, 2020 at 11:24AM PST -The proposed attachment detail is acceptable for the louvers. KNA Ben Pitts -Spacing of louver start location is acceptable at 2'-0" per provided sketch. BNds Leo Contreras			breaking when tryin	g to install and that this type of field install will be		
Attachments: 04-114675_140_010_Lunch Shelter Louver(Approved).pdf PERRIS - B1SS - Proposed Alternative LOUVER DETAILS.pdf Official Response: Leo Contreras (BakerNowicki Design Studio) responded on Wednesday, March 4th, 2020 at 11:24AM PST -The proposed attachment detail is acceptable for the louvers. KNA Ben Pitts -Spacing of louver start location is acceptable at 2'-0" per provided sketch. BNds Leo Contreras			may be shop fabrica	ated, and a bolted connection to allow for increased		
Official Response: Leo Contreras (BakerNowicki Design Studio) responded on Wednesday, March 4th, 2020 at 11:24AM PST -The proposed attachment detail is acceptable for the louvers. KNA Ben Pitts -Spacing of louver start location is acceptable at 2'-0" per provided sketch. BNds Leo Contreras	Additionally, please ve	rify the spacing of the louver start locations requested	on the sketch.			
-The proposed attachment detail is acceptable for the louvers. KNA Ben Pitts -Spacing of louver start location is acceptable at 2'-0" per provided sketch. BNds Leo Contreras		Lunch Shelter Louver(Approved).pdf PERRIS - B1SS	- Proposed Alternat	tive LOUVER DETAILS.pdf		
	-The proposed attachment detail is acceptable for the louvers. KNA Ben Pitts -Spacing of louver start location is acceptable at 2'-0" per provided sketch. BNds Leo Contreras					

COPIES TO

DATE

KCB-1812EN0004 25 Feb 2020 AT: 11:30:57 AM


<u>o</u>

PLOTTED BY:


Please see the attached details for the louver attachment at the Lunch Shelter. There is a concern with the end spacing for the louvers. Please have the Architect verify the spacing in the detail that I have included.

Thanks.

Lonnie Gallaher

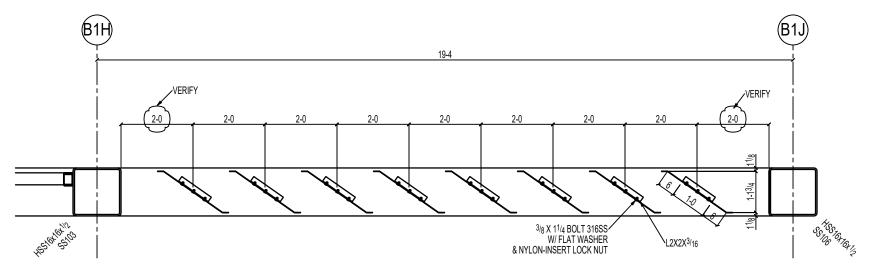

LUNCH SHELTER PARTIAN SECT.

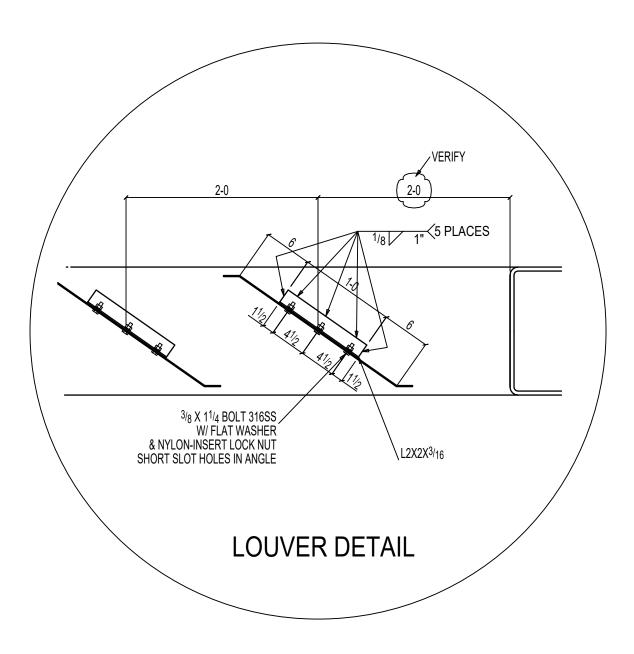




140

APPLICATION FOR APPROVAL OF CONSTRUCTION CHANGE DOCUMENT – CCD CATEGORY A/B

This application is for construction changes, as defined in IR A-6, to approved contract documents. This form shall be completed by the Design Professional in General Responsible Charge of the project, in accordance with California Code of Regulations, Title 24, Part 1, Section 4-338 (c) and in compliance with DSA IR A-6.

· • • • • • • • • • • • • • • • • • • •	(1)		-		
School District/Owner: Perris Unio	on High School District		DSA File #:	33	3 - H8
Project Name/School: Perris High	n School #4		DSA App. #:	04	- 114675
APPLICANT	D. 15- O. 15- 111- d. 07/00/40				
CCD Cat. ⊠A / □B, #:010	Date Submitted:07/26/19	I	d Pages?: ∐No		<i>,</i>
			(attach DSA notifica		g submission).
Firm Name: BakerNowicki Desig	gn Studio		Name: Leo Contr		
Email: lcontreras@bndesignstud	lio.com	Phone N	Number: (619) 795	5-2443	
Address: 731 Ninth Avenue, Suit	te A				
City: San Diego		State: C	Α	Zip: 9210	01
A DSA 301-N, DSA 301-P, or	90-Day Letter has been issued f	or this proj	ject.		
For project currently under co	nstruction.				
☐ To obtain DSA approval of ex	isting uncertified building(s).				
	•	~~~~			
DESIGN PROFESSIONAL IN					
Name of Design Professional i	<u>-</u>	1			
Professional License #: C3024			ne: ARCHITECT	31 - D	.4- 1
Design Professional in General I been examined by me for design in					
Regulations and the project specifi					
Signature:		SPONSIBLE	 CHARGE		
CHECK THIS BOX: ▼ To co				eboot or in	day of
calculations and specifications	s have been stamped and sign	nd, when hed by the	Responsible De	sneet or in esign Profe	essional
listed on DSA 1 for this this pro				J	
Brief description of constructio		neets if ne	eded):		
Louvers revision to Lunch Shelter	on Building B1.				
List of DSA approved drawing	a affacted by this CCD: AFO 4	0 0 CD4 0	0		
List of DSA approved drawings	3 allected by this CCD. AES.1.	2 & SD1-3	.2		
DSA USE ONLY			DSA	Stamp	
SSSJCDate_08.06.19(Approved) D	For business office use Disapproved / Not Reg'd Date Sent 08.06	19		OVED	
	Disapproved Not Req'd Return By AH Delivery Method BC	I	DIVISION OF THE S	STATE ARCI	HITECT
ACS Date Approved / D	Benvery Metalou		ACS _ FLS	SSR _	GC
Remarks Seal on drawing SB1-3	.2 is expired.		Λ# 04- 114675	DATE: 08	N6 19

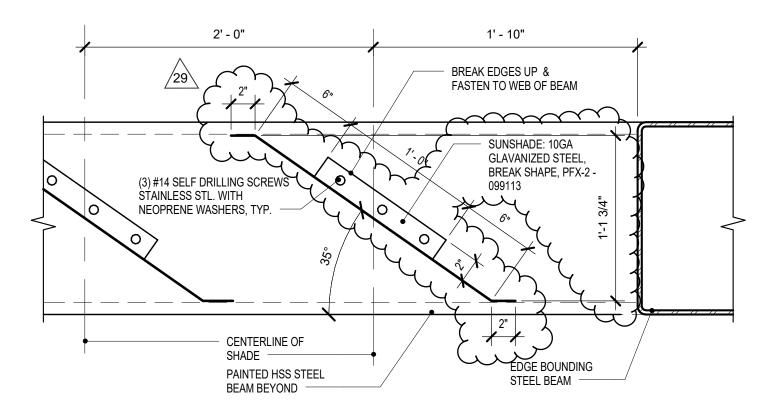

(13) (AB1-4.2)

LUNCH SHELTER LOUVER SECTION


1 1/2" = 1'-0"

APPROVED


DIVISION OF THE STATE ARCHITECT

ACS -- FLS -- SSR GC

A# 04- 114675 DATE: 08.06.19

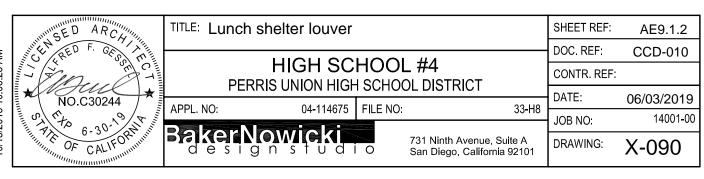

10/18/2018 10:05:23 AM

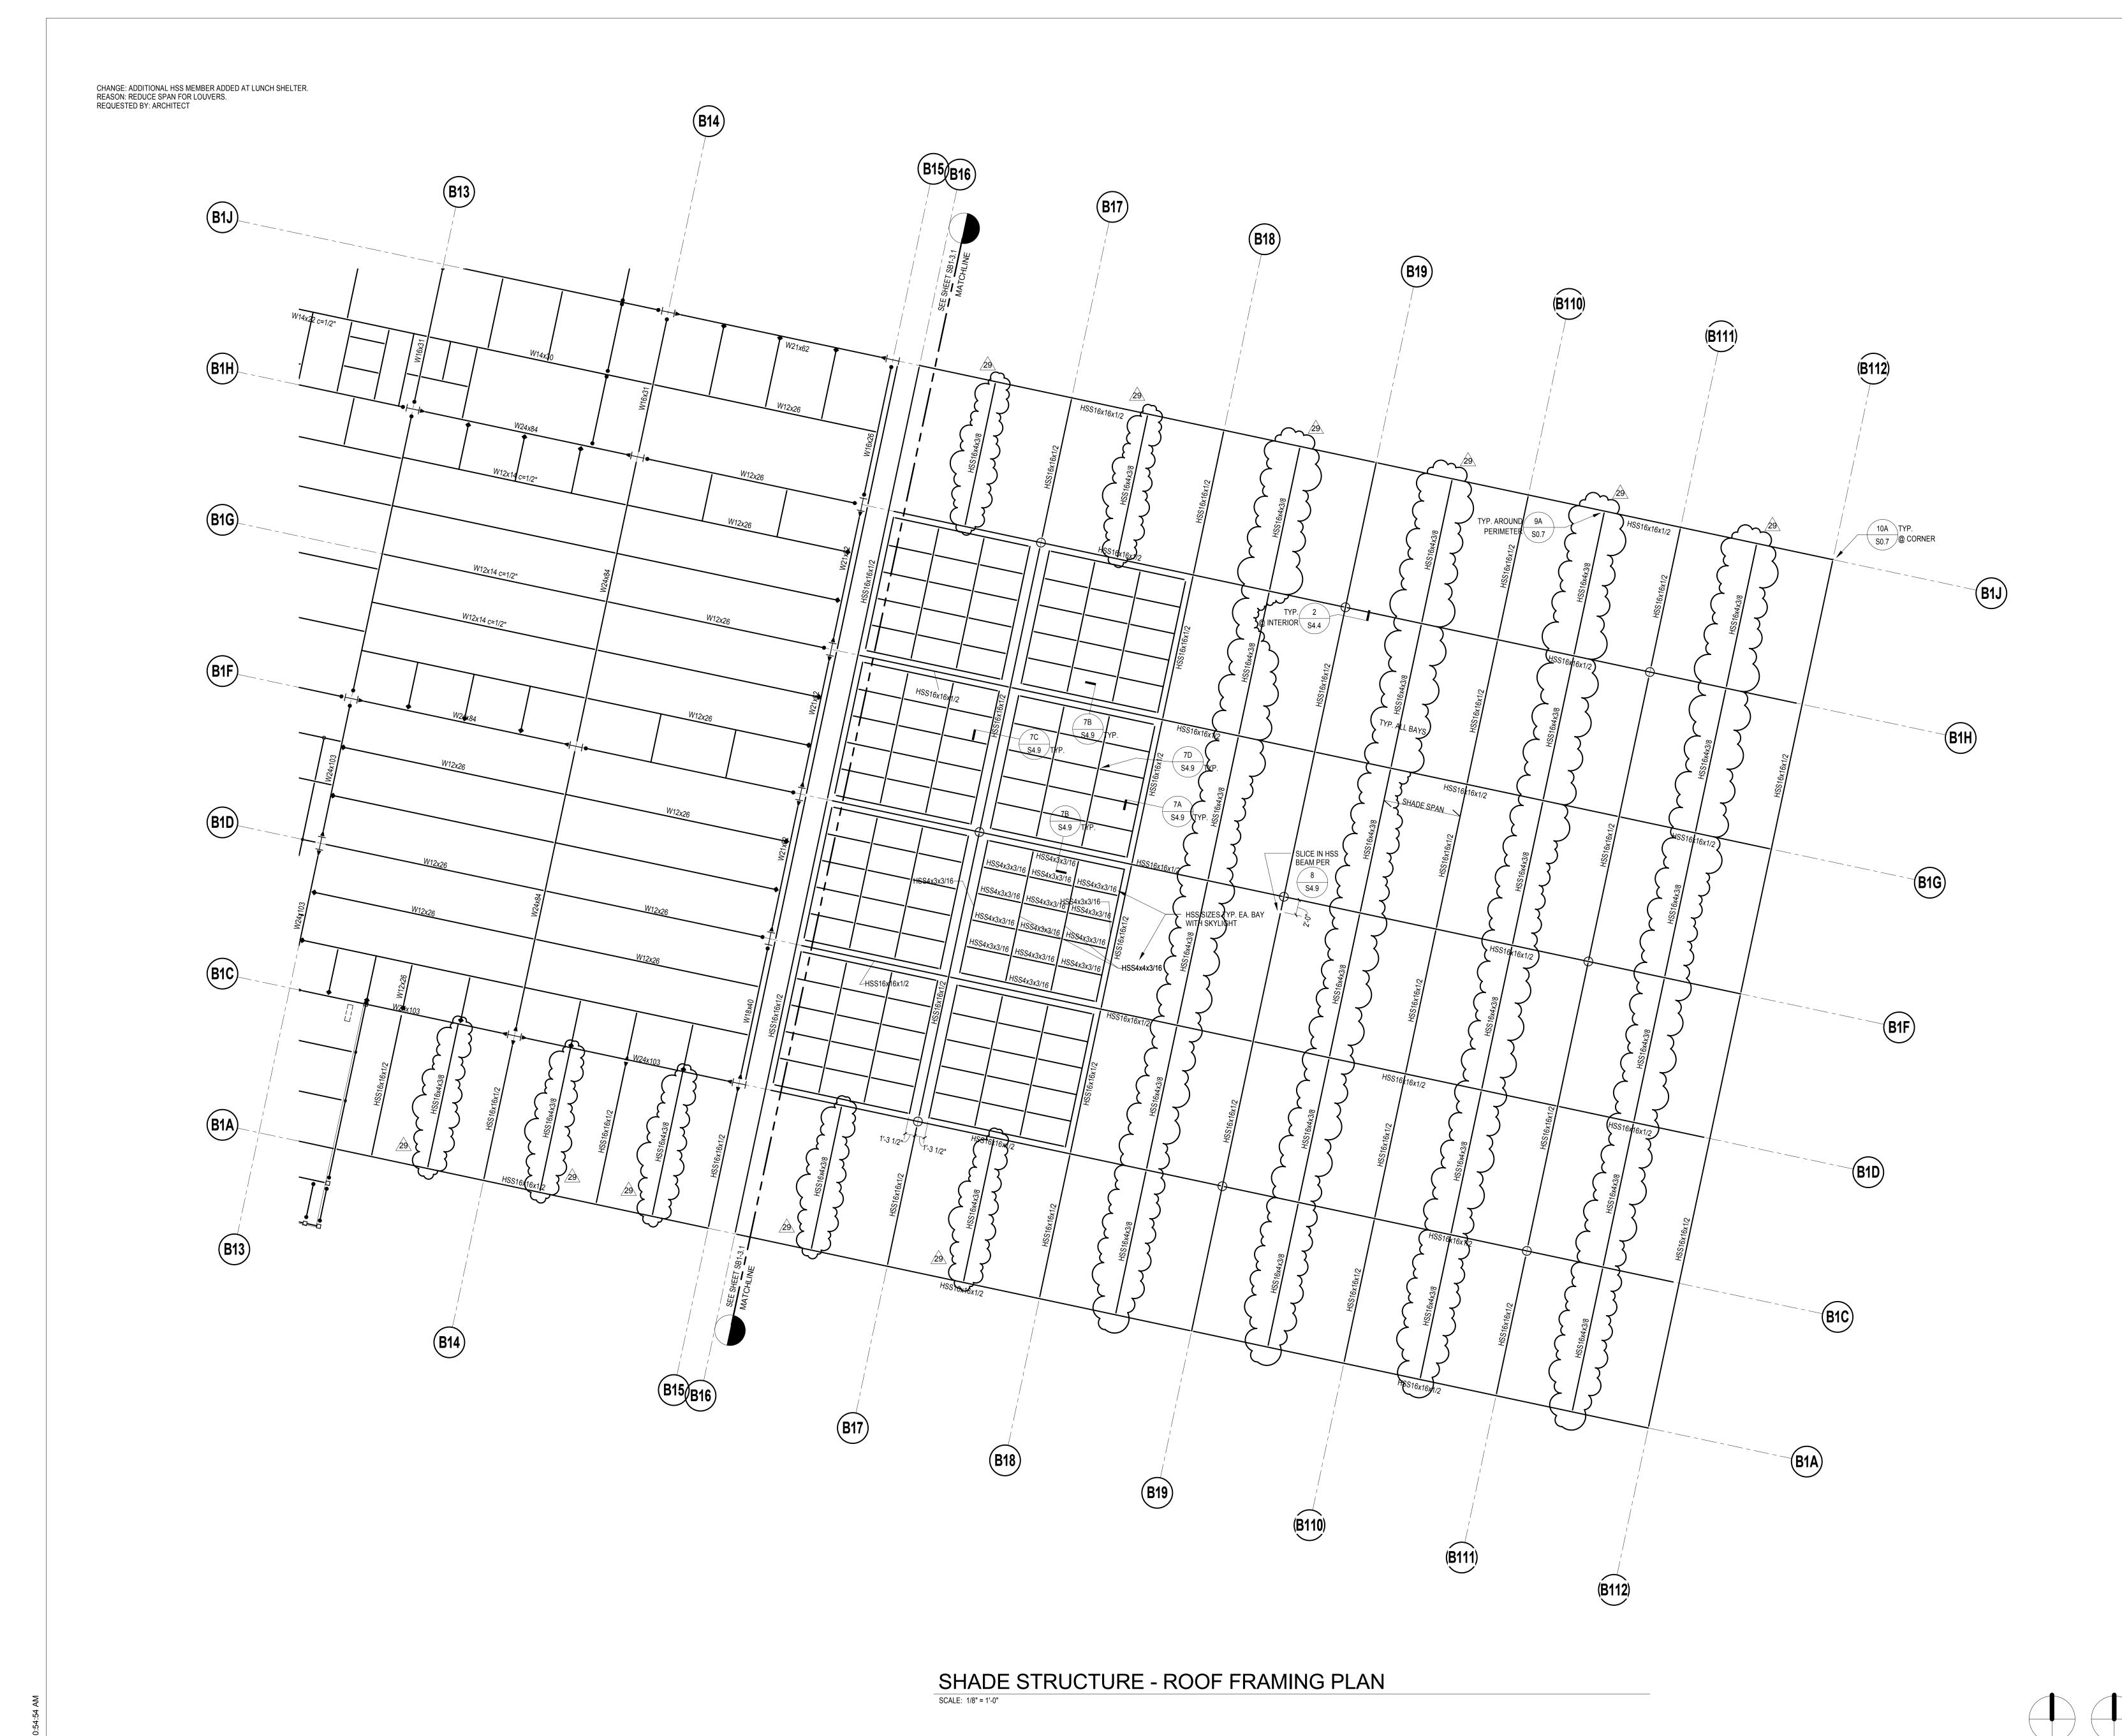

www.bndesignstudio.com

PERRIS UNION HIGH SCHOOL DISTRICT HIGH SCHOOL #4

ROOF FRAMING PLAN NOTES

1. SEE SHEETS S0.1 THROUGH S0.11 FOR GENERAL NOTES AND TYPICAL DETAILS.

2. FOR ANY DIMENSIONAL INFORMATION NOT SHOWN, SEE ARCHITECTURAL DRAWINGS.

3. SEE ARCHITECTURAL, PLUMBING, MECHANICAL AND ELECTRICAL DRAWINGS FOR SIZE AND LOCATION OF ROOF OPENINGS NOT SHOWN ON ROOF FRAMING PLANS. SEE DETAIL 5/S0.9 FOR TYPICAL OPENINGS, UNLESS NOTED OTHERWISE.

4. ALL BEAMS SHALL BE EQUALLY SPACED BETWEEN COLUMNS, UNLESS NOTED OTHERWISE.

5. "MU" DENOTES MECHANICAL UNIT. MAXIMUM ALLOWABLE WEIGHT IS SHOWN. SEE MECHANICAL AND ARCHITECTURAL DRAWINGS FOR EXACT SIZE AND WEIGHT OF MECHANICAL UNITS. FOR TYPICAL FRAMING AT MECHANICAL UNITS, SEE DETAILS 1/S0.9 AND 2/S0.9.

6. THE CONTRACTOR SHALL COORDINATE LOCATION OF ALL FRAMING BEAMS AT MECHANICAL UNITS WITH MECHANICAL DRAWINGS. THE LOCATION OF FRAMING SHALL MATCH CURB LAYOUT AND ROOF PENETRATIONS FOR THE SUPPLIED UNITS.

LEGEND

[+ 15'-0"] : INDICATES TOP OF STEEL ELEVATION. : INDICATES NUMBER OF 3/4" DIA. NELSON STUD ANCHORS. FOR ADDITIONAL INFORMATION SEE DETAIL 10/S0.8.

: INDICATES SPAN OF METAL DECK & TYPE. DECK SPAN INDICATED SHALL BE TYPICAL, UNLESS NOTED OTHERWISE. DECK SHALL SPAN OVER 2 SPANS MINIMUM (3 SUPPORTS) AND 3 SPANS (4 SUPPORTS) WHEREVER POSSIBLE. SEE FLOOR AND ROOF CONSTRUCTION SCHEDULE ON DETAIL 1/S0.8 FOR STRUCTURAL DECK AND FILL REQUIREMENTS.

: INDICATES AMOUNT OF CAMBER IN STEEL BEAM. NO CAMBER REQUIRED WHERE NONE SHOWN. : INDICATES TYPICAL WELDED CONNECTION WITH ASTM A325SC BOLTS PER 6/S0.7.

: INDICATES TYPICAL CONNECTION WITH ASTM : INDICATES WELDED MOMENT CONNECTION PER 4/S0.7, 7/S0.7, OR 3/S0.6 U.N.O. AS A SIDEPLATE

CONNECTION ON MOMENT FRAME ELEVATIONS.

: INDICATES ROOF DRAIN OPENING W/ STEEL SUPPORT PER DETAIL 5/S0.9. : INDICATES MECH. UNIT W/ MAX. WEIGHT SHOWN.

: INDICATES LEVEL ROOF CURB PER DETAIL 3/S0.9.

: INDICATES A LINE OF FRAMING PART OF THE SEISMIC FORCE RESISTING SYSTEM. ALL WELDING SHALL CONFORM TO AWS D1.1 & D1.8.

FIELD LEVEL, COACHES LEVEL (+24"), CAMPUS LEVEL (L1 +4")

CONSULTANT

Consulting Engineers, Inc.
9931 Muirlands Boulevard, Irvine, CA 92618
Tel (949) 462-3200, Fax (949) 462-3201

KNA JOB NO.: 323.009 IDENTIFICATION STAMP

> OFFICE OF REGULATION SERVICES APPL # 04-114675 AC _____ F/LS____ SS ____

BLDG. B1 - SHADE STRUCTURE ROOF FRAMING PLAN

NO. DATE ISSUE 1 01-16-19 Addendum #4 29 05-06-19 CCD 10A

PROJECT NO:

SB1-3.2 X-091

STRUCTURAL CALCULATIONS

FOR

PERRIS HIGH SCHOOL #4

Perris, CA

KNA No. 323.009

May 3, 2019

Prepared Under the Direction of:



APPROVED
DIVISION OF THE STATE ARCHITECT

ACS _ -- FLS _ -- SSR _ GC

A# 04- 114675 DATE: 08.06.19

Larry R. Kaprielian

Registered Structural Engineer, S.E. 2795 (CA)



SHEET	_1 _{OF} 3
JOB NO	323.009
DATE	
BY	BP

CLIENT

LUNCH SHELTER - ADDED BEAM

CHECK HSS MID-SPAN BEAM

Span = 19'

Wwind = 19'/2(10.4psf) = 99plf; See wind load on next sht.

 $M = WL^2/8 = (99plf)(19)^2/8 = 53.6k-in$

Try HSS16x4x3/8

Mallow = Zfy/1.67 = (60.2)(46ksi)/1.67 = 1658 k-in OK

PROVIDE HSS16x4X3/8


Perris HS #4

BP

BY

CLIENT

LUNCH SHELTER - SHADE FIN DESIGN

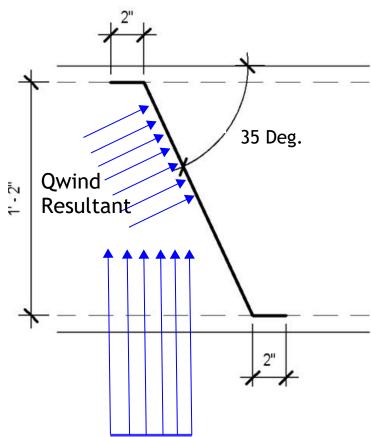

Qwind UPLIFT = 40.8PSF (0.6 ASD); Per original **Calculations**

= 24.5 psf

Qwind Resultant = (24.5psf)(sin (55)20.1psf

 $M = WL^2/8$

 $= (20.1 psf)(17.4"/12")(9.33')^2 / 8$

= 317 ft-lbs = 3.805 k-in

Mallow = fb $Zy/1.67 = (50ksi)(0.54in^3)/1.67 = 4.71 k-in > 3.805 k-in$

OK

REVIEWED BY

 Company
 :
 May 3, 2019

 Designer
 :
 09:39 AM


 Job Number:
 Checked By:_____

Section Properties: Section1

=	3	
=	17.414	in
=	3.621	in
=	-0.252	in
=	1.947	in
=	8.707	in
=	8.707	in
=	1.811	in
=	1.810	in
	= = = =	= 17.414 = 3.621 = -0.252 = 1.947 = 8.707 = 8.707 = 1.811

Equivalent Properties:

•			
Area, Ax	=	2.614	in^2
Inertia, Ixx	=	0.562	in^4
Inertia, lyy	=	77.931	in^4
Inertia, Ixy	=	3.937	in^4
Modulus, Sx(Top)	=	0.311	in^3
Modulus, Sx(Bot)	=	0.311	in^3
Modulus, Sy(Left)	=	8.951	in^3
Modulus, Sy(Right)	=	8.950	in^3
Radius, rx	=	0.464	in
Radius, ry	=	5.460	in
Plastic Modulus, Zx	=	0.540	in^3
Plastic Modulus, Zy	=	12.464	in^3
Torsional, J	=	<no calc.=""></no>	

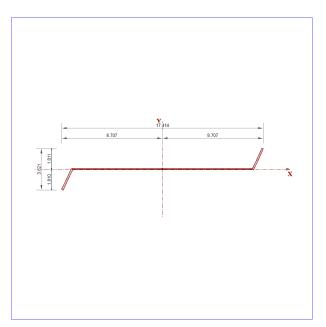

Section Diagram

C:\RISA\SectionProject1 Page 1